

JANUARY 2022

**EAST BAY PLAIN SUBBASIN  
GROUNDWATER SUSTAINABILITY PLAN  
APPENDIX 4**

PREPARED FOR

East Bay Municipal Utility District GSA and  
City of Hayward GSA



PREPARED BY

Luhdorff & Scalmanini Consulting Engineers  
Geosyntec  
Brown and Caldwell  
Environmental Science Associates  
Dr. Jean Moran  
Farallon Geographics



## **APPENDIX 4**


- Appendix 4.A. EBMUD GSA Projects Supporting Information
- Appendix 4.B. EBMUD GSA Management Actions Supporting Information
- Appendix 4.C. Hayward GSA Projects Supporting Information
- Appendix 4.D. Hayward GSA Management Actions Supporting Information

## APPENDIX 4.A.

### **EBMUD GSA Project Supporting Information**

## Appendix 4.A

### **EBMUD GSA Project Supporting Information**

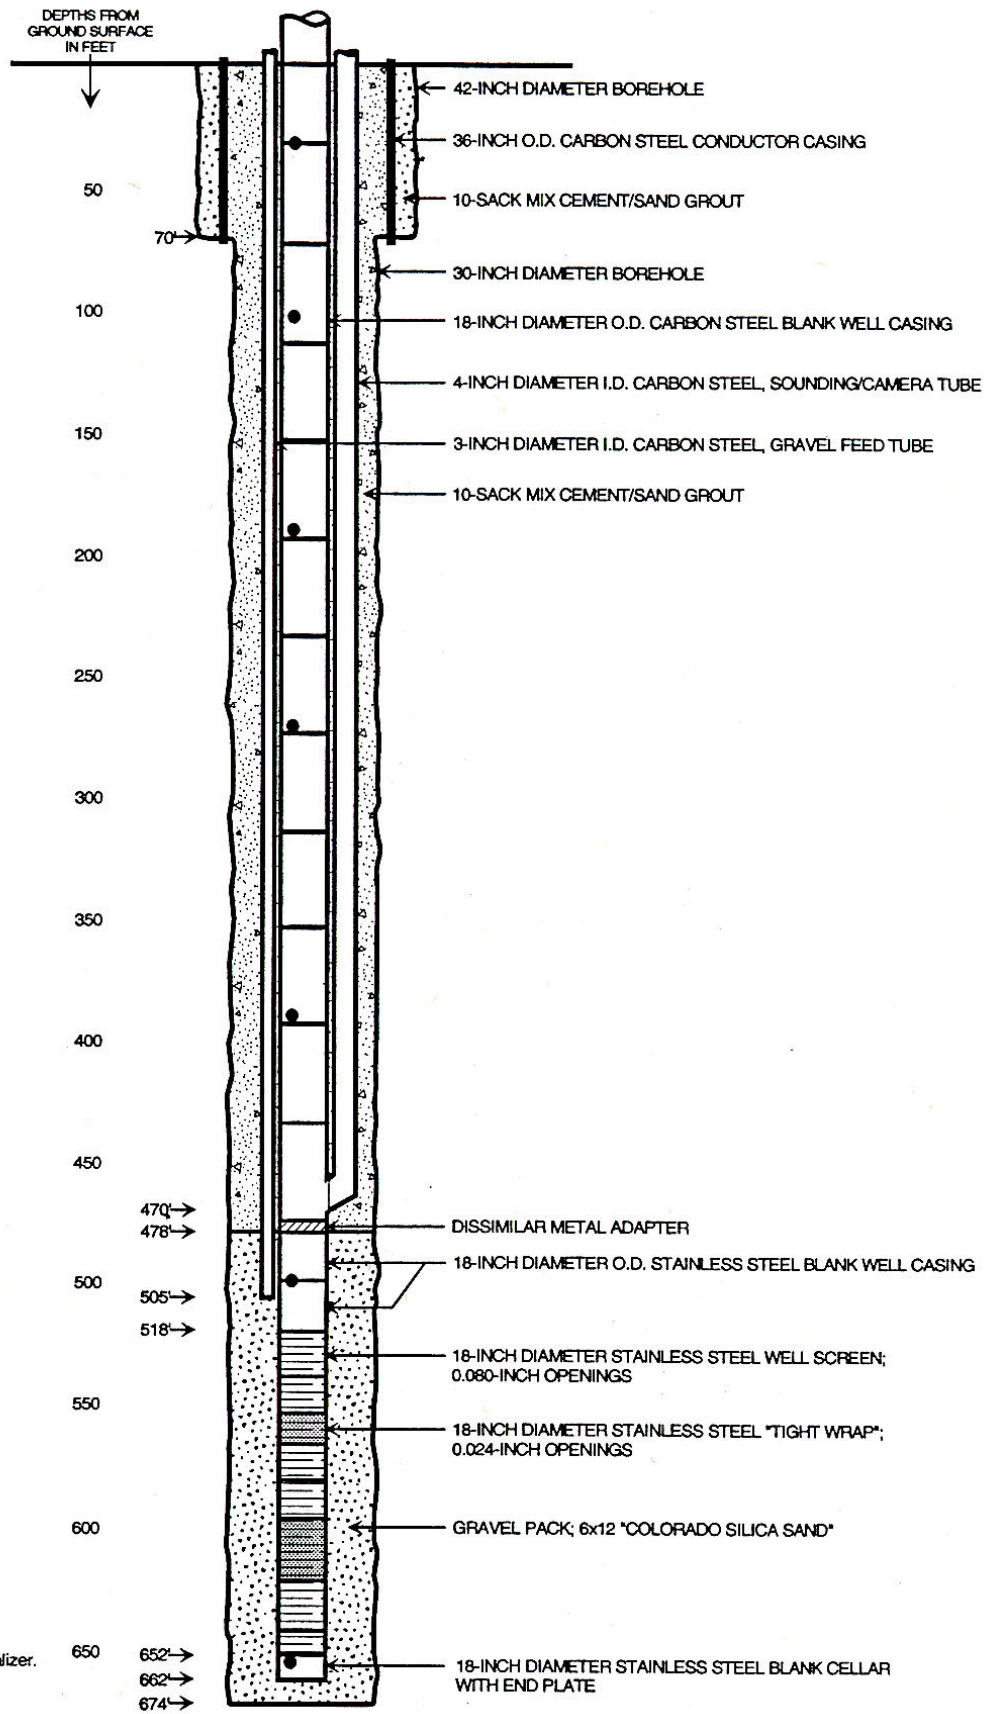


**FIGURE 2-5**  
**WELL DIAGRAM FOR BAYSIDE WELL NO. 1**  
 EAST BAY MUNICIPAL UTILITY DISTRICT  
 BAYSIDE GROUNDWATER PROJECT  
 DRAFT EIR

Source: Fugro 1998

# Future Scenario

## Pumping and Injection of Future Projects

### Groundwater Pumping/Injection in Acre-Feet (AF)

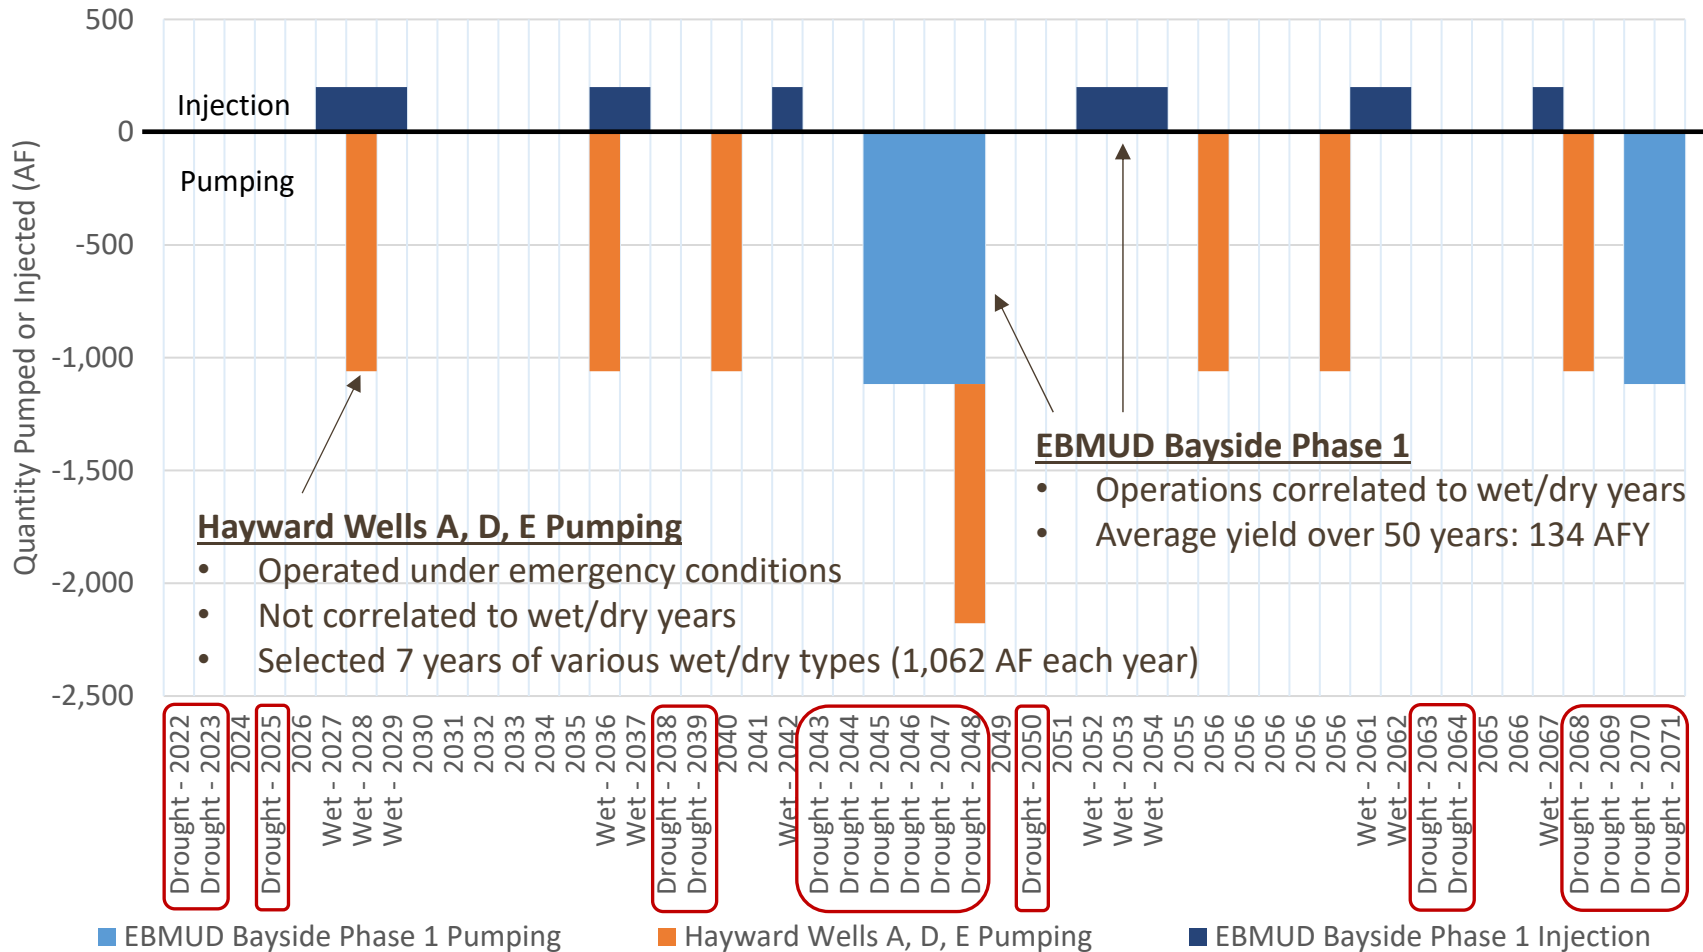

## APPENDIX 4.B.

### **EBMUD GSA Management Actions Supporting Information**

Table 4B-1. EBMUD Management Action Implementation Costs

Work Item	2022	2023	2024	2025	2026	2027	2028	2029	2030	2031	10-Year Total	Initial 5-Year Total
Annual Reporting	\$48,750	\$32,500	\$32,500	\$32,500	\$32,500	\$32,500	\$32,500	\$32,500	\$32,500	\$32,500	\$341,250	\$178,750
Data Management System	\$5,000	\$5,000	\$5,000	\$5,000	\$5,000	\$5,000	\$5,000	\$5,000	\$5,000	\$5,000	\$50,000	\$25,000
GSP 5-year Updates					\$162,500					\$162,500	\$325,000	\$162,500
RMS GW Level Monitoring	\$14,500	\$14,500	\$14,500	\$14,500	\$14,500	\$14,500	\$14,500	\$14,500	\$14,500	\$14,500	\$145,000	\$72,500
Monitoring Network (in addition to RMS Wells)	\$20,000	\$20,000	\$20,000	\$20,000	\$20,000	\$20,000	\$20,000	\$20,000	\$20,000	\$20,000	\$200,000	\$100,000
Baseline RMS WQ Sampling			\$44,000	\$44,000							\$88,000	\$88,000
RMS WQ Sampling (TDS, nitrate, arsenic, chloride)	\$22,000	\$22,000	\$22,000	\$22,000	\$22,000	\$22,000	\$22,000	\$22,000	\$22,000	\$22,000	\$220,000	\$110,000
Update WQ Plume Info		\$6,500		\$6,500		\$6,500		\$6,500		\$6,500	\$32,500	\$13,000
Fate & Transport Modeling					\$65,000					\$65,000	\$130,000	\$65,000
Extensometer Monitoring	\$15,500	\$15,500	\$15,500	\$15,500	\$15,500	\$15,500	\$15,500	\$15,500	\$15,500	\$15,500	\$155,000	\$77,500
Shallow Wells Near Creeks (10)			\$115,000								\$115,000	\$115,000
Shallow Well Level Monitoring			\$7,000	\$7,000	\$7,000	\$7,000	\$7,000	\$7,000	\$7,000	\$7,000	\$56,000	\$21,000
Shallow Well WQ Monitoring			\$10,000	\$10,000	\$10,000	\$10,000	\$10,000	\$10,000	\$10,000	\$10,000	\$80,000	\$30,000
Install New Nested Wells (3)			\$400,000								\$400,000	\$400,000
New Nested Wells GW Level Monitoring			\$7,000	\$7,000	\$7,000	\$7,000	\$7,000	\$7,000	\$7,000	\$7,000	\$56,000	\$21,000
New Nested Wells WQ Sampling			\$10,000	\$10,000	\$10,000	\$10,000	\$10,000	\$10,000	\$10,000	\$10,000	\$80,000	\$30,000
Install Stream Gages (2)			\$32,500	\$32,500							\$65,000	\$65,000
Stream Gauge Monitoring			\$17,500	\$35,000	\$35,000	\$35,000	\$35,000	\$35,000	\$35,000	\$35,000	\$262,500	\$87,500
Synoptic Stream Monitoring	\$15,000	\$15,000	\$15,000	\$15,000	\$15,000	\$15,000	\$15,000	\$15,000	\$15,000	\$15,000	\$150,000	\$75,000
Isotopic Sampling			\$100,000								\$100,000	\$100,000
Baseline Habitat Survey (1 Event)			\$150,000								\$150,000	\$150,000
Habitat Survey (Every 5 Years)					\$50,000					\$50,000	\$100,000	\$50,000
<b>Total (including capital costs; every five year costs)</b>	<b>\$140,750</b>	<b>\$131,000</b>	<b>\$1,017,500</b>	<b>\$276,500</b>	<b>\$471,000</b>	<b>\$200,000</b>	<b>\$193,500</b>	<b>\$200,000</b>	<b>\$193,500</b>	<b>\$477,500</b>	<b>\$3,301,250</b>	<b>\$2,036,750</b>
<b>Total (ongoing annual costs only)</b>	<b>\$140,750</b>	<b>\$131,000</b>	<b>\$176,000</b>	<b>\$200,000</b>	<b>\$193,500</b>	<b>\$200,000</b>	<b>\$193,500</b>	<b>\$200,000</b>	<b>\$193,500</b>	<b>\$200,000</b>	<b>\$1,828,250</b>	<b>\$841,250</b>

Costs above don't include EBMUD/Hayward Staff time to meet with stakeholders, provide Board updates, DMS capital costs/maintenance, etc.

Capital or one-time costs

Every five year costs




APPENDIX 4.C.

**Hayward GSA Projects Supporting Information**

## Appendix 4.C

### Hayward GSA Projects Supporting Information

91-2-109

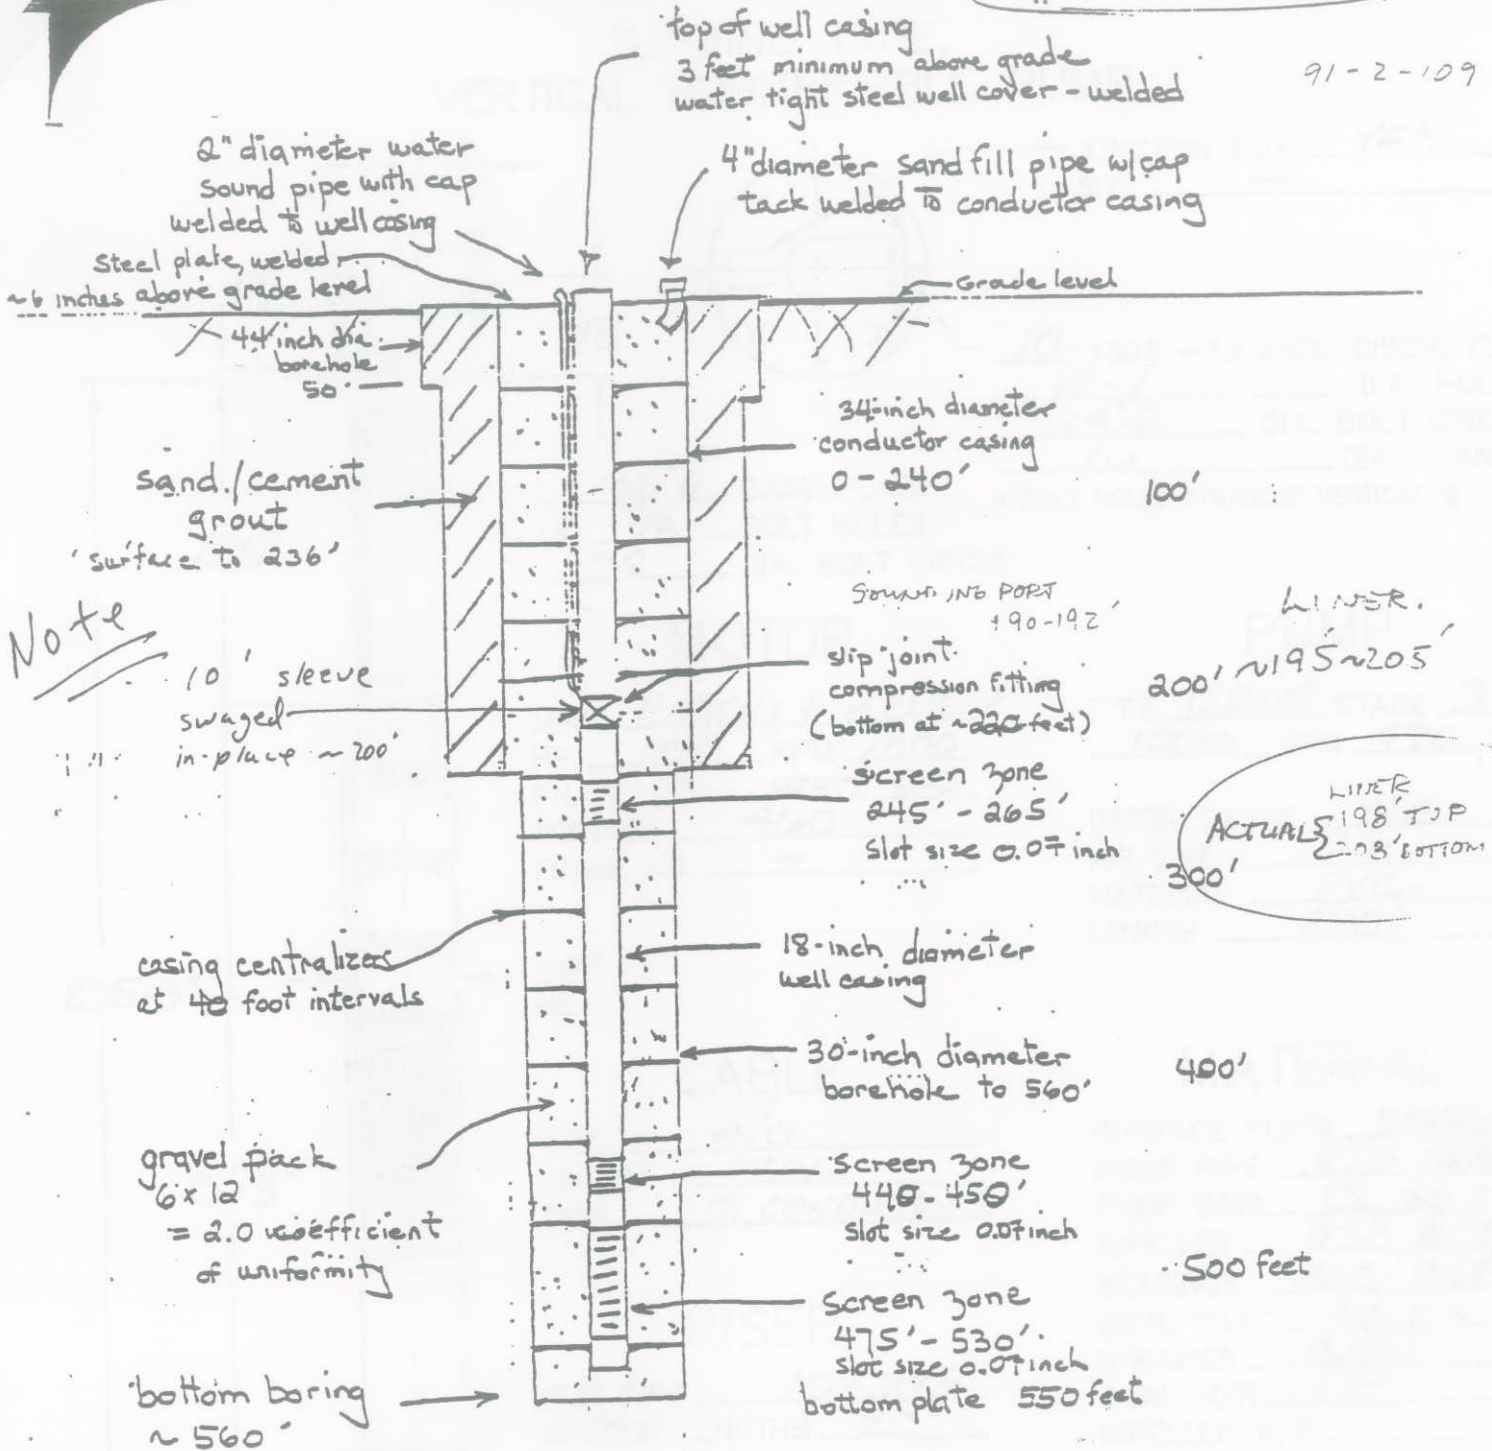


FINAL DESIGN OF  
EMERGENCY SUPPLY WELL No. 1


7/14/81

Prepared by  
AQUIFER SCIENCES INC. /  
ENTRIX INC.  
Rebecca Sterbenz  
Grace Haggerty


**TEST HOLE LITHOLOGY**

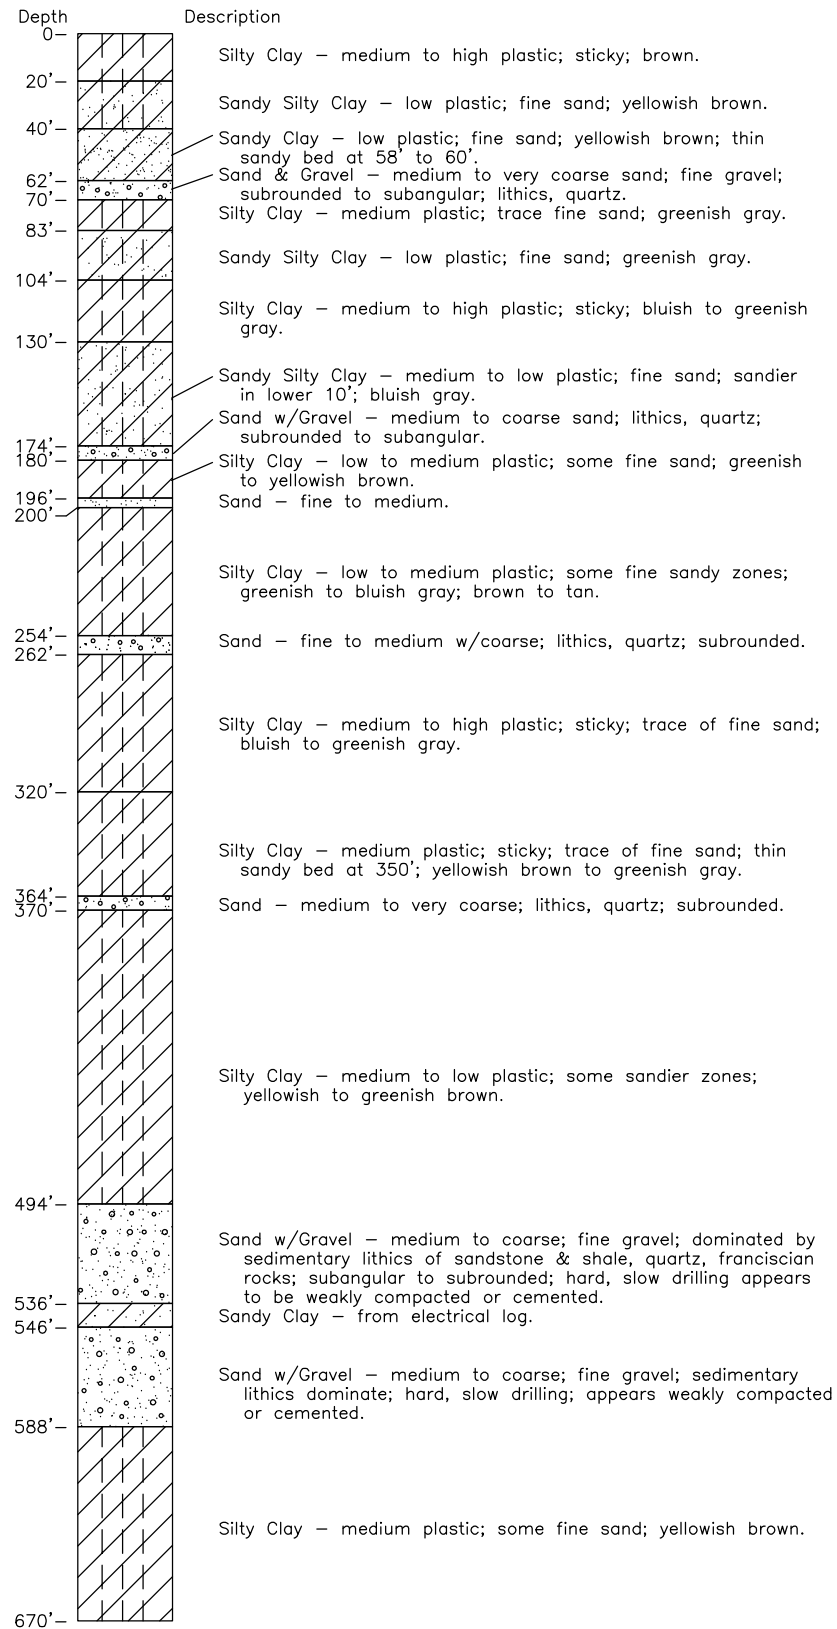

**TEST HOLE GEOPHYSICAL SURVEY**

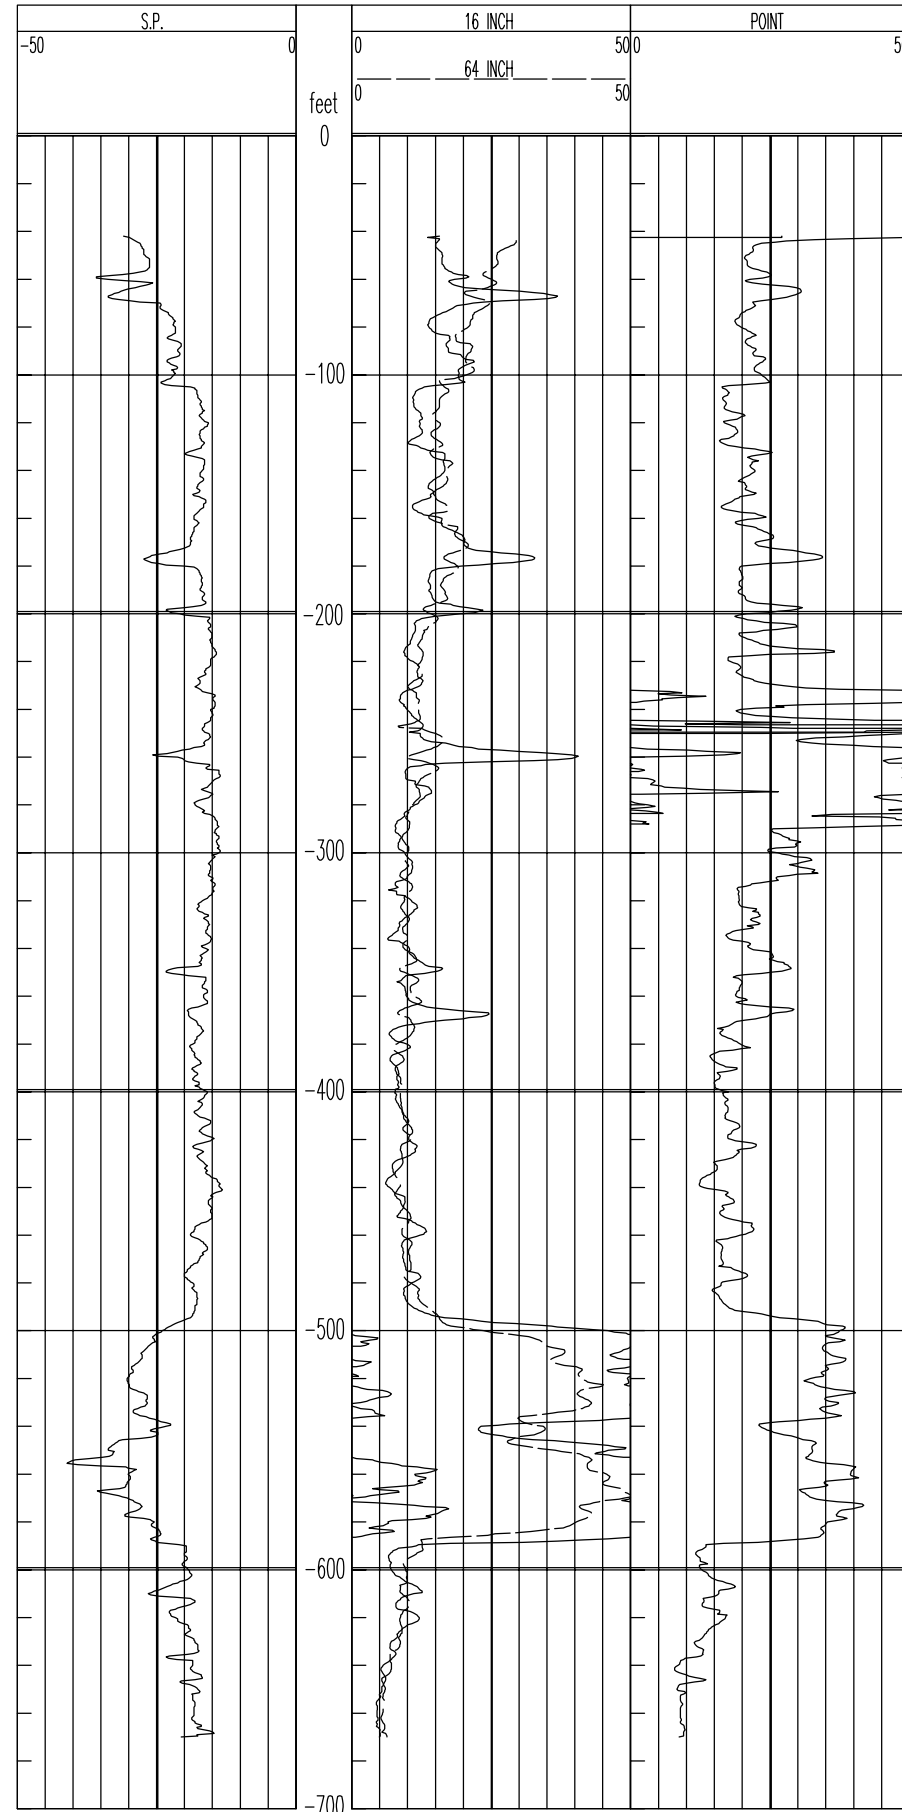

**WELL D-2 AS-BUILT**

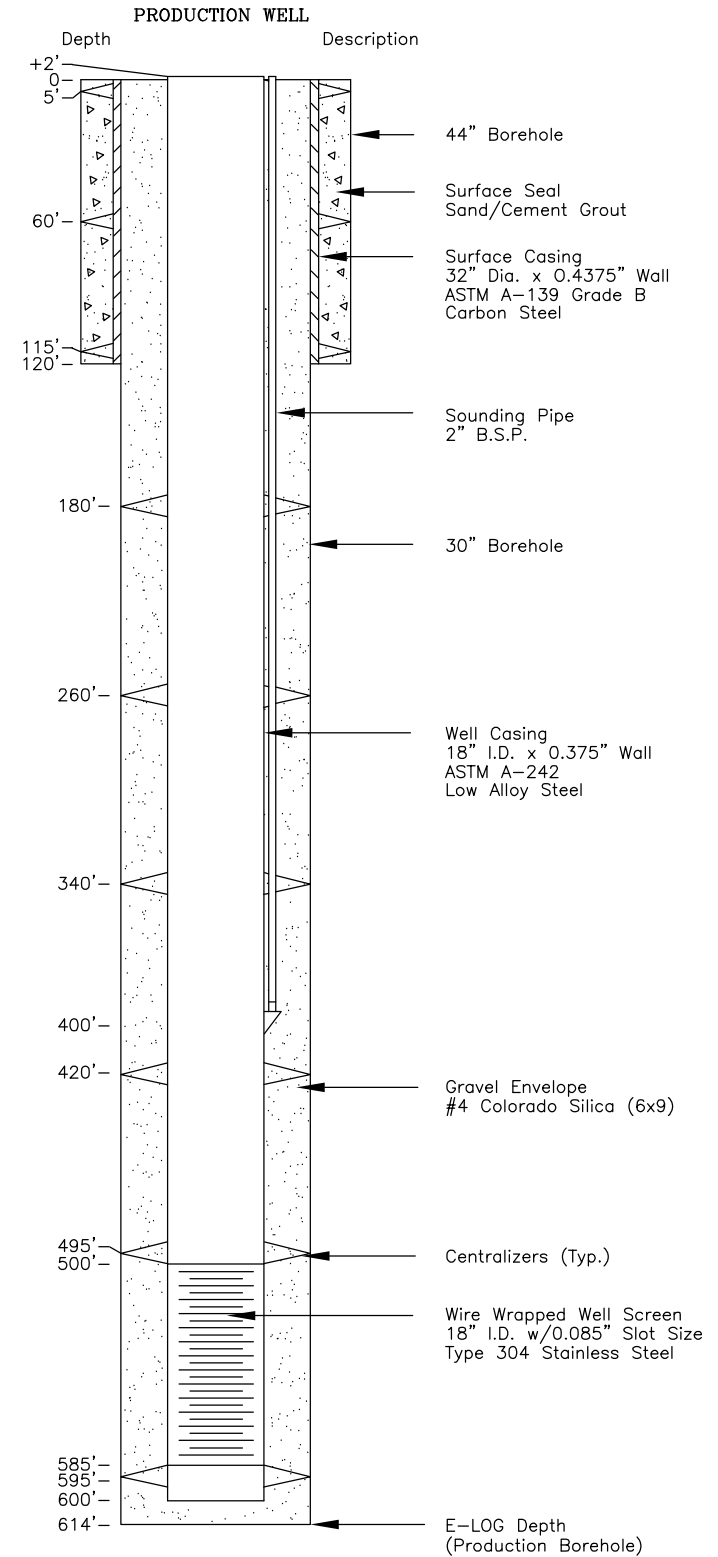

**AS-BUILT**

CAD FILE: C:\Projects\City of Hayward\95-2-132\Tehap\95-2-132.dwg DATE: 03-17-10 1:44pm

**EMERGENCY WATER SUPPLY WELL D**  
**PHASE I - DRILLING & CONSTRUCTION**  
**HAYWARD AIRPORT SITE**  
**WELL PROFILE**

SHEET NO. 5  
TOTAL SHEETS: 5  
FILE NO.: E-1500

SCALE: 1" = 40'  
DATE: JUNE 1993

PROJ. NO.: 7103  
DATE: JUNE 1993


DESIGNED BY: TDE/LCS  
CHECKED BY: LHE  
DRAWN BY: LDC  
APPROVED BY: [Signature]

CITY OF HAYWARD  
DEPARTMENT OF PUBLIC WORKS  
ENGINEERING DIVISION


LUHDORFF & SCALMANINI  
Consulting Engineers  
Woodland, California 95695  
92-2-085 TEHAP3

CAD FILE: G:/Projects/City of Hayward/98-2-011/SH\_4(ab).dwg CFG FILE: LSCE2500.PCP\_MRG DATE: 03-17-10 1:49pm

**Test Hole Lithology**

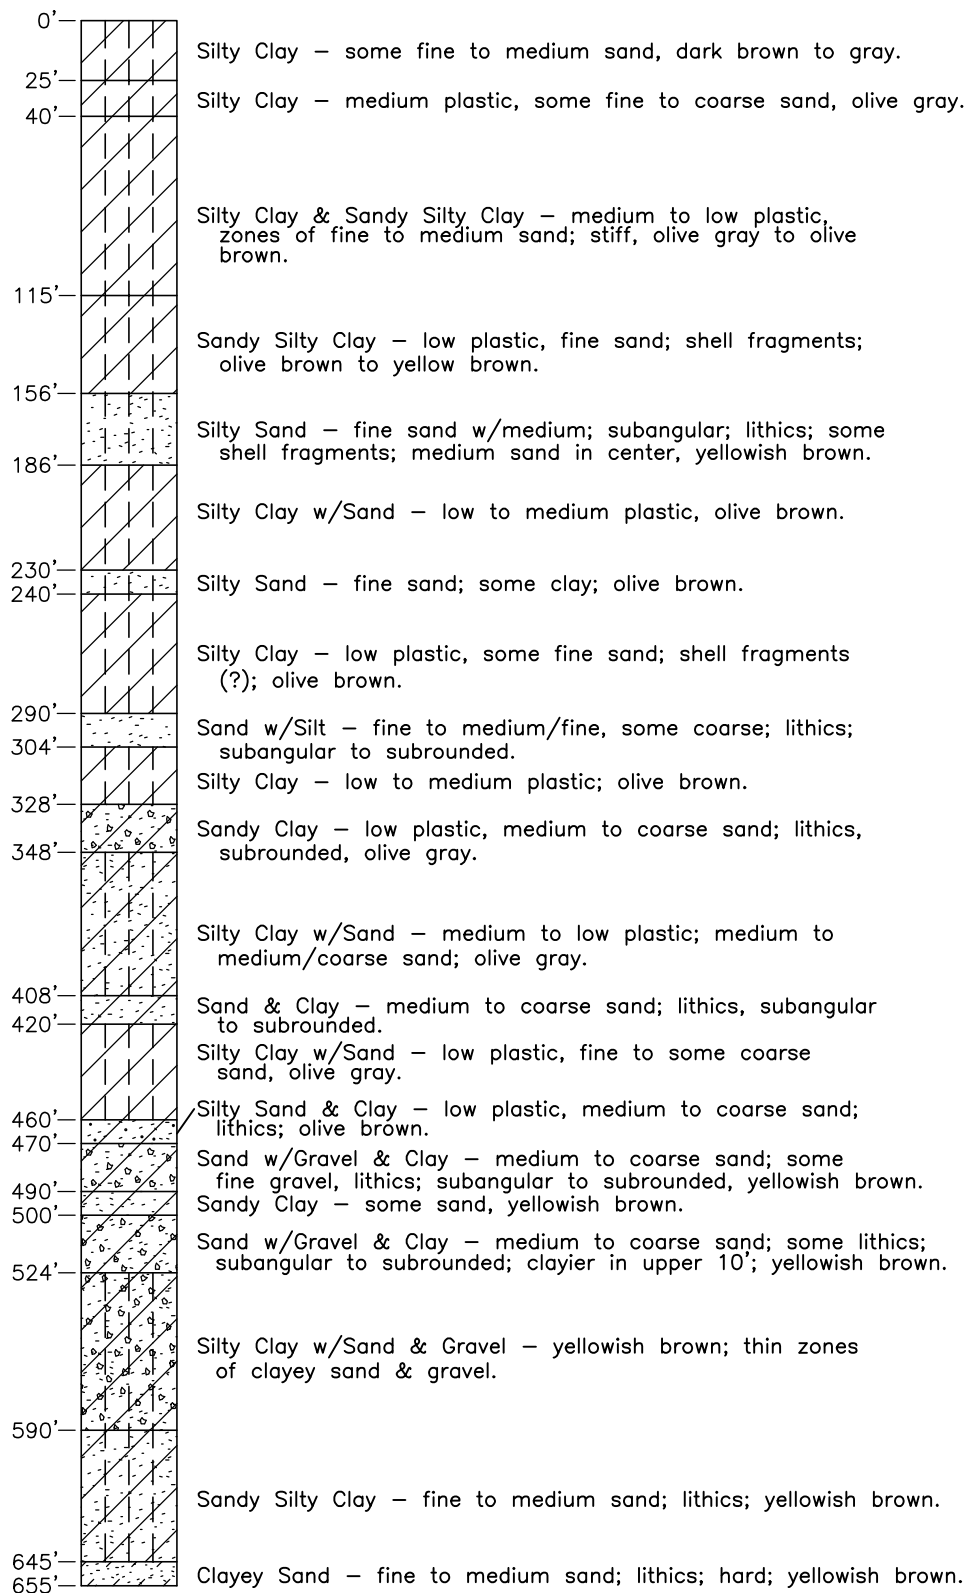


**Test Hole Electrical Log**

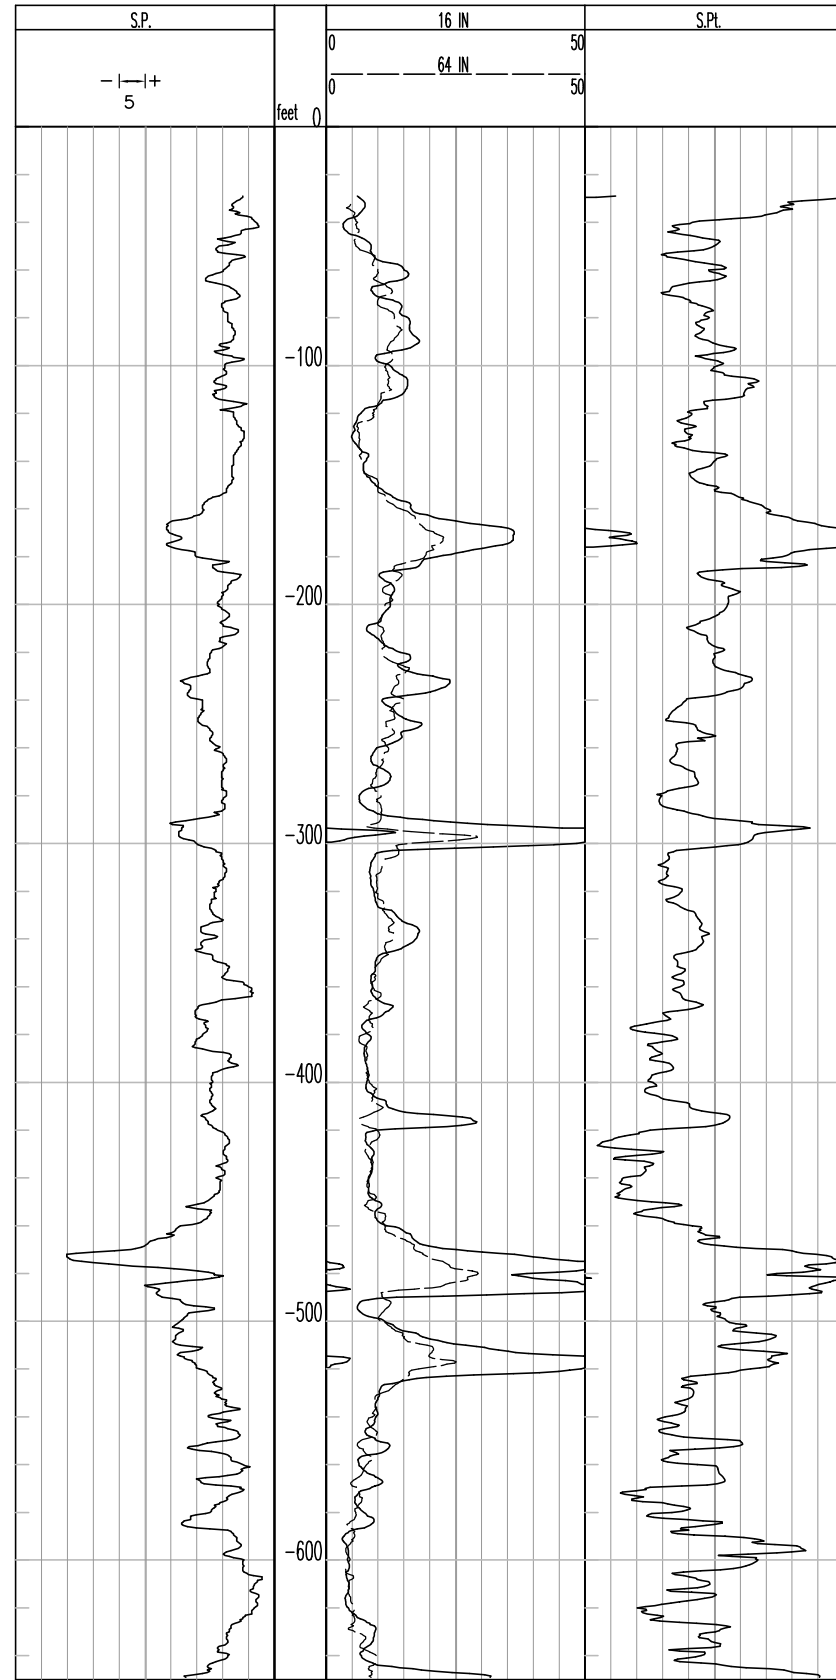

E-Log by WELENCO 4/8/98

**Water Supply Well E**

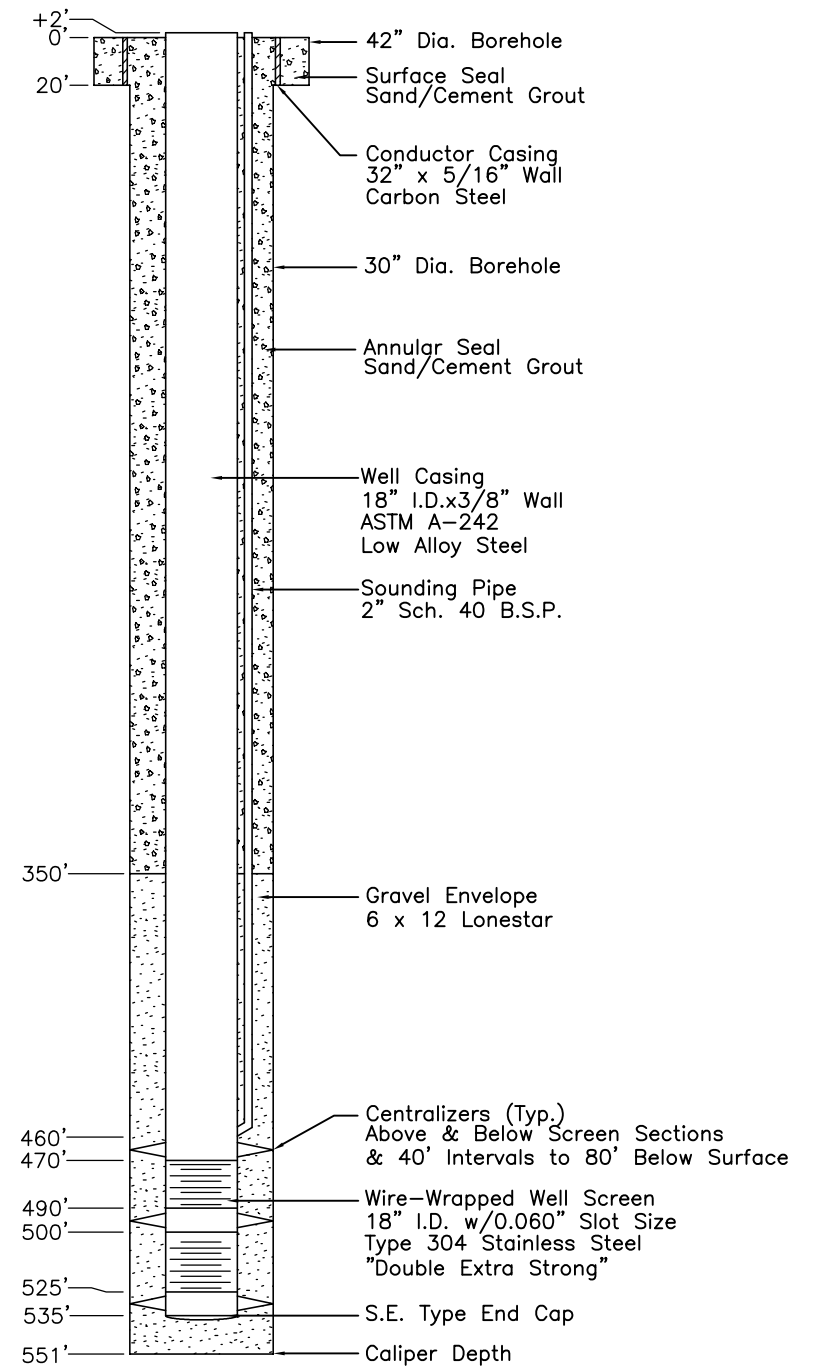

EMERGENCY WATER SUPPLY WELL E  
 28251 INDUSTRIAL BLVD.  
 WELL PROFILE  
 TOTAL SHEETS: 6  
 FILE NO.: E-1498  
 SHEET NO. 4

CITY OF HAYWARD  
 DEPARTMENT OF PUBLIC WORKS  
 ENGINEERING DIVISION  
 DESIGNED BY: TDE/LCS  
 DRAWN BY: LDC  
 APPROVED BY: [Signature]  
 DATE: JAN 1999  
 PROJ. NO.: 7110  
 SCALE: NONE

NO.	DATE	DESCRIPTION
1	12/28/98	1st Issue by City


LUHDORFF & SCALMANINI  
 Consulting Engineers  
 Woodland, California 95695  
 98-2-011 HW2.DWG

**AS-BUILT**

# Future Scenario

## Pumping and Injection of Future Projects

### Groundwater Pumping/Injection in Acre-Feet (AF)

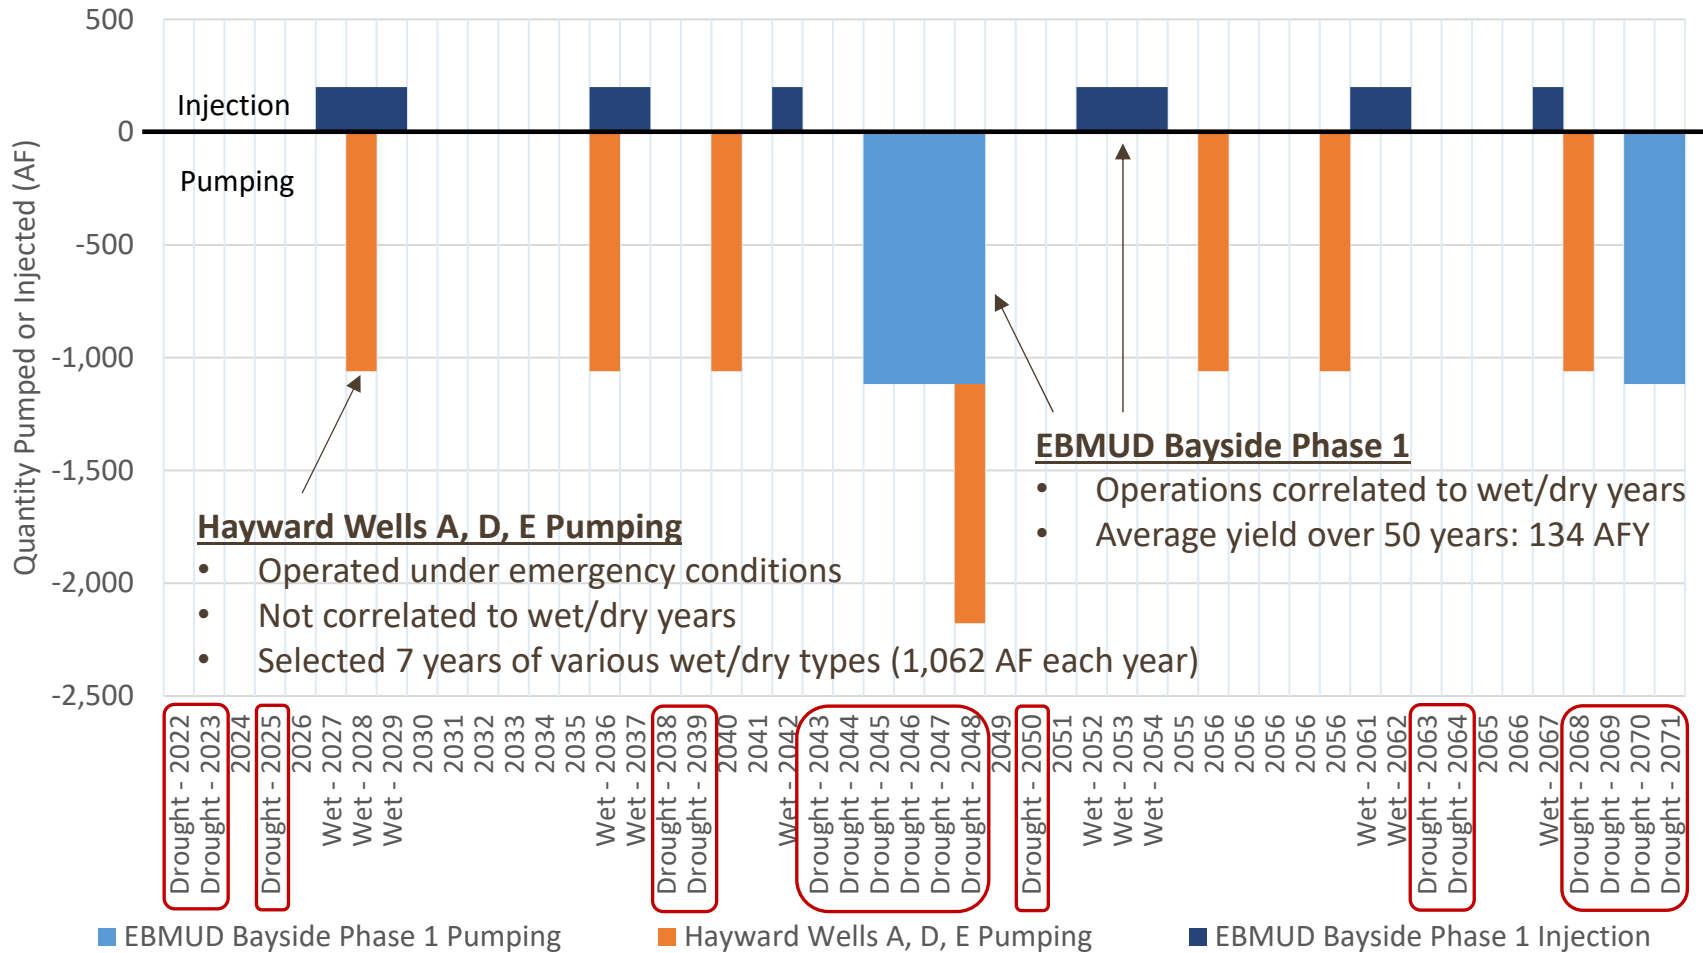

APPENDIX 4.D.

**Hayward GSA Management Actions Supporting Information**

Table 4D-1. Hayward Management Action Implementation Costs

Work Item	2022	2023	2024	2025	2026	2027	2028	2029	2030	2031	10-Year Total	Initial 5-Year Total
Annual Reporting	\$26,250	\$17,500	\$17,500	\$17,500	\$17,500	\$17,500	\$17,500	\$17,500	\$17,500	\$17,500	\$183,750	\$96,250
Data Management System	\$5,000	\$5,000	\$5,000	\$5,000	\$5,000	\$5,000	\$5,000	\$5,000	\$5,000	\$5,000	\$50,000	\$25,000
GSP 5-year Updates					\$87,500					\$87,500	\$175,000	\$87,500
RMS GW Level Monitoring	\$5,500	\$5,500	\$5,500	\$5,500	\$5,500	\$5,500	\$5,500	\$5,500	\$5,500	\$5,500	\$55,000	\$27,500
Monitoring Network (in addition to RMS Wells)	\$5,000	\$5,000	\$5,000	\$5,000	\$5,000	\$5,000	\$5,000	\$5,000	\$5,000	\$5,000	\$50,000	\$25,000
Baseline RMS WQ Sampling			\$16,000	\$16,000							\$32,000	\$32,000
RMS WQ Sampling (TDS, nitrate, arsenic, chloride)	\$8,000	\$8,000	\$8,000	\$8,000	\$8,000	\$8,000	\$8,000	\$8,000	\$8,000	\$8,000	\$80,000	\$40,000
Update WQ Plume Info		\$3,500		\$3,500		\$3,500		\$3,500		\$3,500	\$17,500	\$7,000
Fate & Transport Modeling					\$35,000					\$35,000	\$70,000	\$35,000
Extensometer Monitoring											\$0	\$0
Shallow Wells Near Creeks (10)											\$0	\$0
Shallow Well Level Monitoring											\$0	\$0
Shallow Well WQ Monitoring											\$0	\$0
Install New Nested Wells (3)											\$0	\$0
New Nested Wells GW Level Monitoring											\$0	\$0
New Nested Wells WQ Sampling											\$0	\$0
Install Stream Gages (2)											\$0	\$0
Stream Gauge Monitoring											\$0	\$0
Synoptic Stream Monitoring											\$0	\$0
Isotopic Sampling											\$0	\$0
Baseline Habitat Survey (1 Event)											\$0	\$0
Habitat Survey (Every 5 Years)											\$0	\$0
<b>Total (including capital costs; every five year costs)</b>	<b>\$49,750</b>	<b>\$44,500</b>	<b>\$57,000</b>	<b>\$60,500</b>	<b>\$163,500</b>	<b>\$44,500</b>	<b>\$41,000</b>	<b>\$44,500</b>	<b>\$41,000</b>	<b>\$167,000</b>	<b>\$713,250</b>	<b>\$375,250</b>
<b>Total (ongoing annual costs only)</b>	<b>\$49,750</b>	<b>\$44,500</b>	<b>\$41,000</b>	<b>\$44,500</b>	<b>\$41,000</b>	<b>\$44,500</b>	<b>\$41,000</b>	<b>\$44,500</b>	<b>\$41,000</b>	<b>\$44,500</b>	<b>\$436,250</b>	<b>\$220,750</b>

Costs above don't include EBMUD/Hayward Staff time to meet with stakeholders, provide Board updates, DMS capital costs/maintenance, etc.

Capital or one-time costs  
Every five year costs